Furnished floor plan / R06

Scale 1:60 at A3. Bedroom entrances updated from the owner green markup.



REVIEW R06 - BEDROOM DOOR RELOCATION / UNITS mm

[A] assumed / [E] notebook / [R] reference or review item

R06: bedroom entrances moved per green markup; C02 shortened with owner approval.

Source main-room label 5410 reconciled to 5400. Opening widths inferred from trace.

BEDROOM ENTRANCES

D05: main bedroom, 900 mm nominal width. D07: children, 850 mm. Both shift 900 mm east; exact translations are inferred from the sketch.

MASTER ENTRY

A 100 mm return forms a recessed entry. The former master doorway becomes open access from the hall into that recess.

CHILD WARDROBE

C02 is 1950 x 600 mm, with a 100 mm reveal beside D07. The owner approved shortening it to clear the new opening.

PRESERVED CAD

Other furniture and openings retain their issued R05 CAD positions. Structural columns and the original source DWG are preserved.

WEBSITE UPDATE

The same door positions, widths, return and C02 size are applied to the website. Its later furniture, finishes and balcony changes are retained.


VERIFIED

Native AutoCAD audit: zero errors. Reusable door blocks and 18 editable dimension entities are retained. Door swings clear furniture.

Print A3 at 100%. Dimensions in millimetres.

Bedroom entrances / detail

Scale 1:20 at A3. Green identifies the revised doors and review labels.

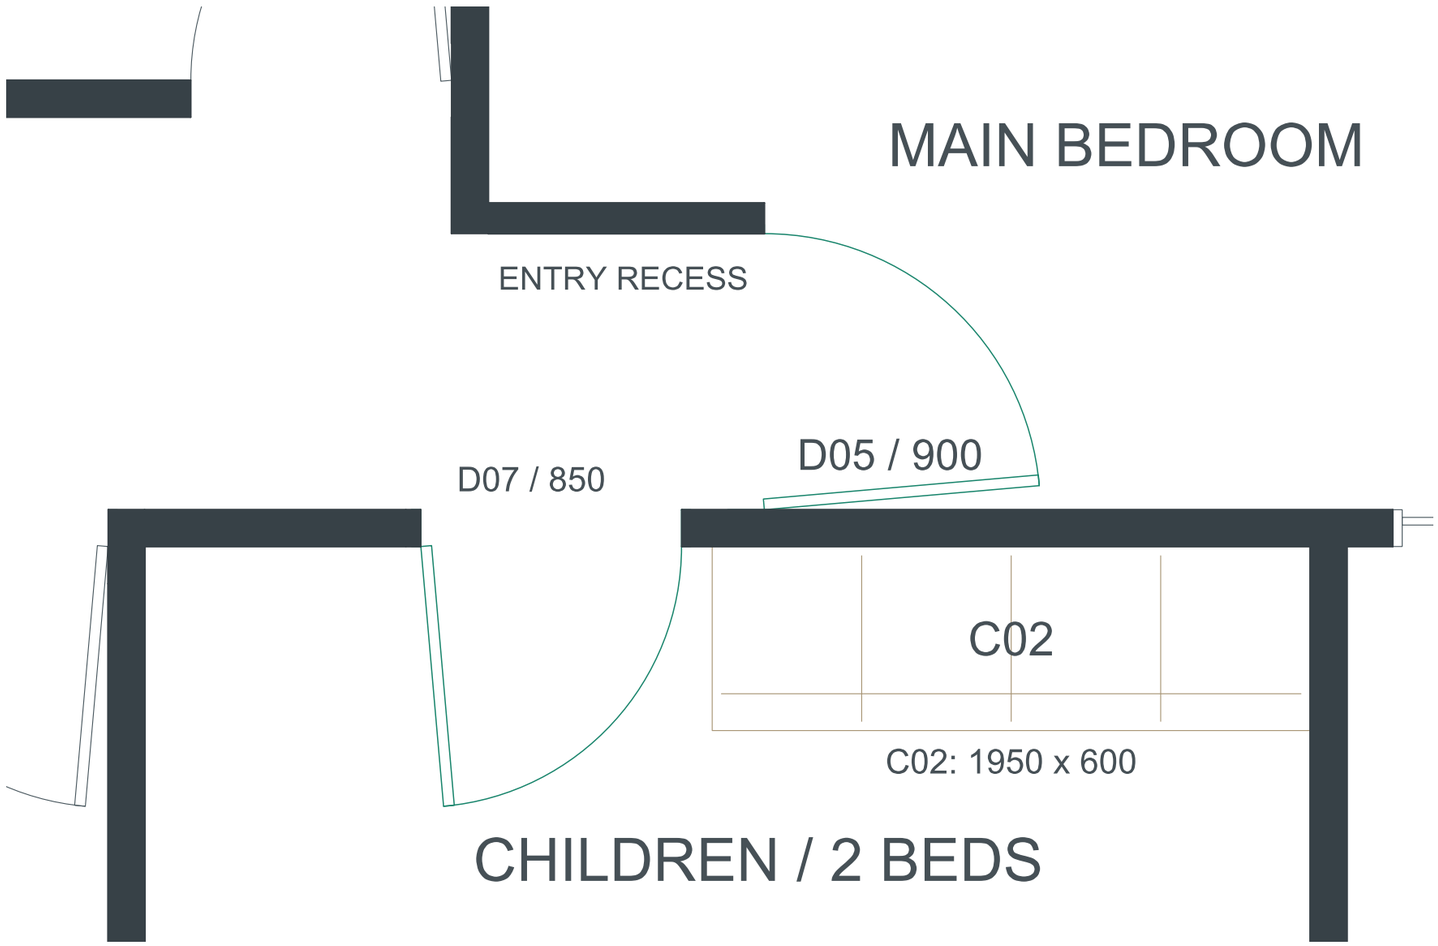

D05 / MAIN BEDROOM

Pivot: X 9620, sheet Y 7090. Width 900. The leaf opens into the bedroom. The old west opening remains doorless access to the entry recess.

D07 / CHILDREN

Pivot: X 8500, sheet Y 7210. Width 850. The leaf opens into the room; the former opening near the family door is infilled.

C02 / 1950 x 600

Wardrobe starts at X 9450. Its left edge is 100 mm past the right jamb of the new child doorway.

100 mm RETURN

Return: X 8720 to 9620, sheet Y 6090 to 6190. In the website, gaps between master wardrobe sections close while their supplied dimensions stay intact.

DRAWING BASIS

This PDF is plotted from the verified native R06 DWG round-trip. The image provides a layout instruction, not surveyed door locations.

Print A3 at 100%. Dimensions in millimetres.